


ALBERTA LAND SURVEYOR'S REAL PROPERTY REPORT

STREET

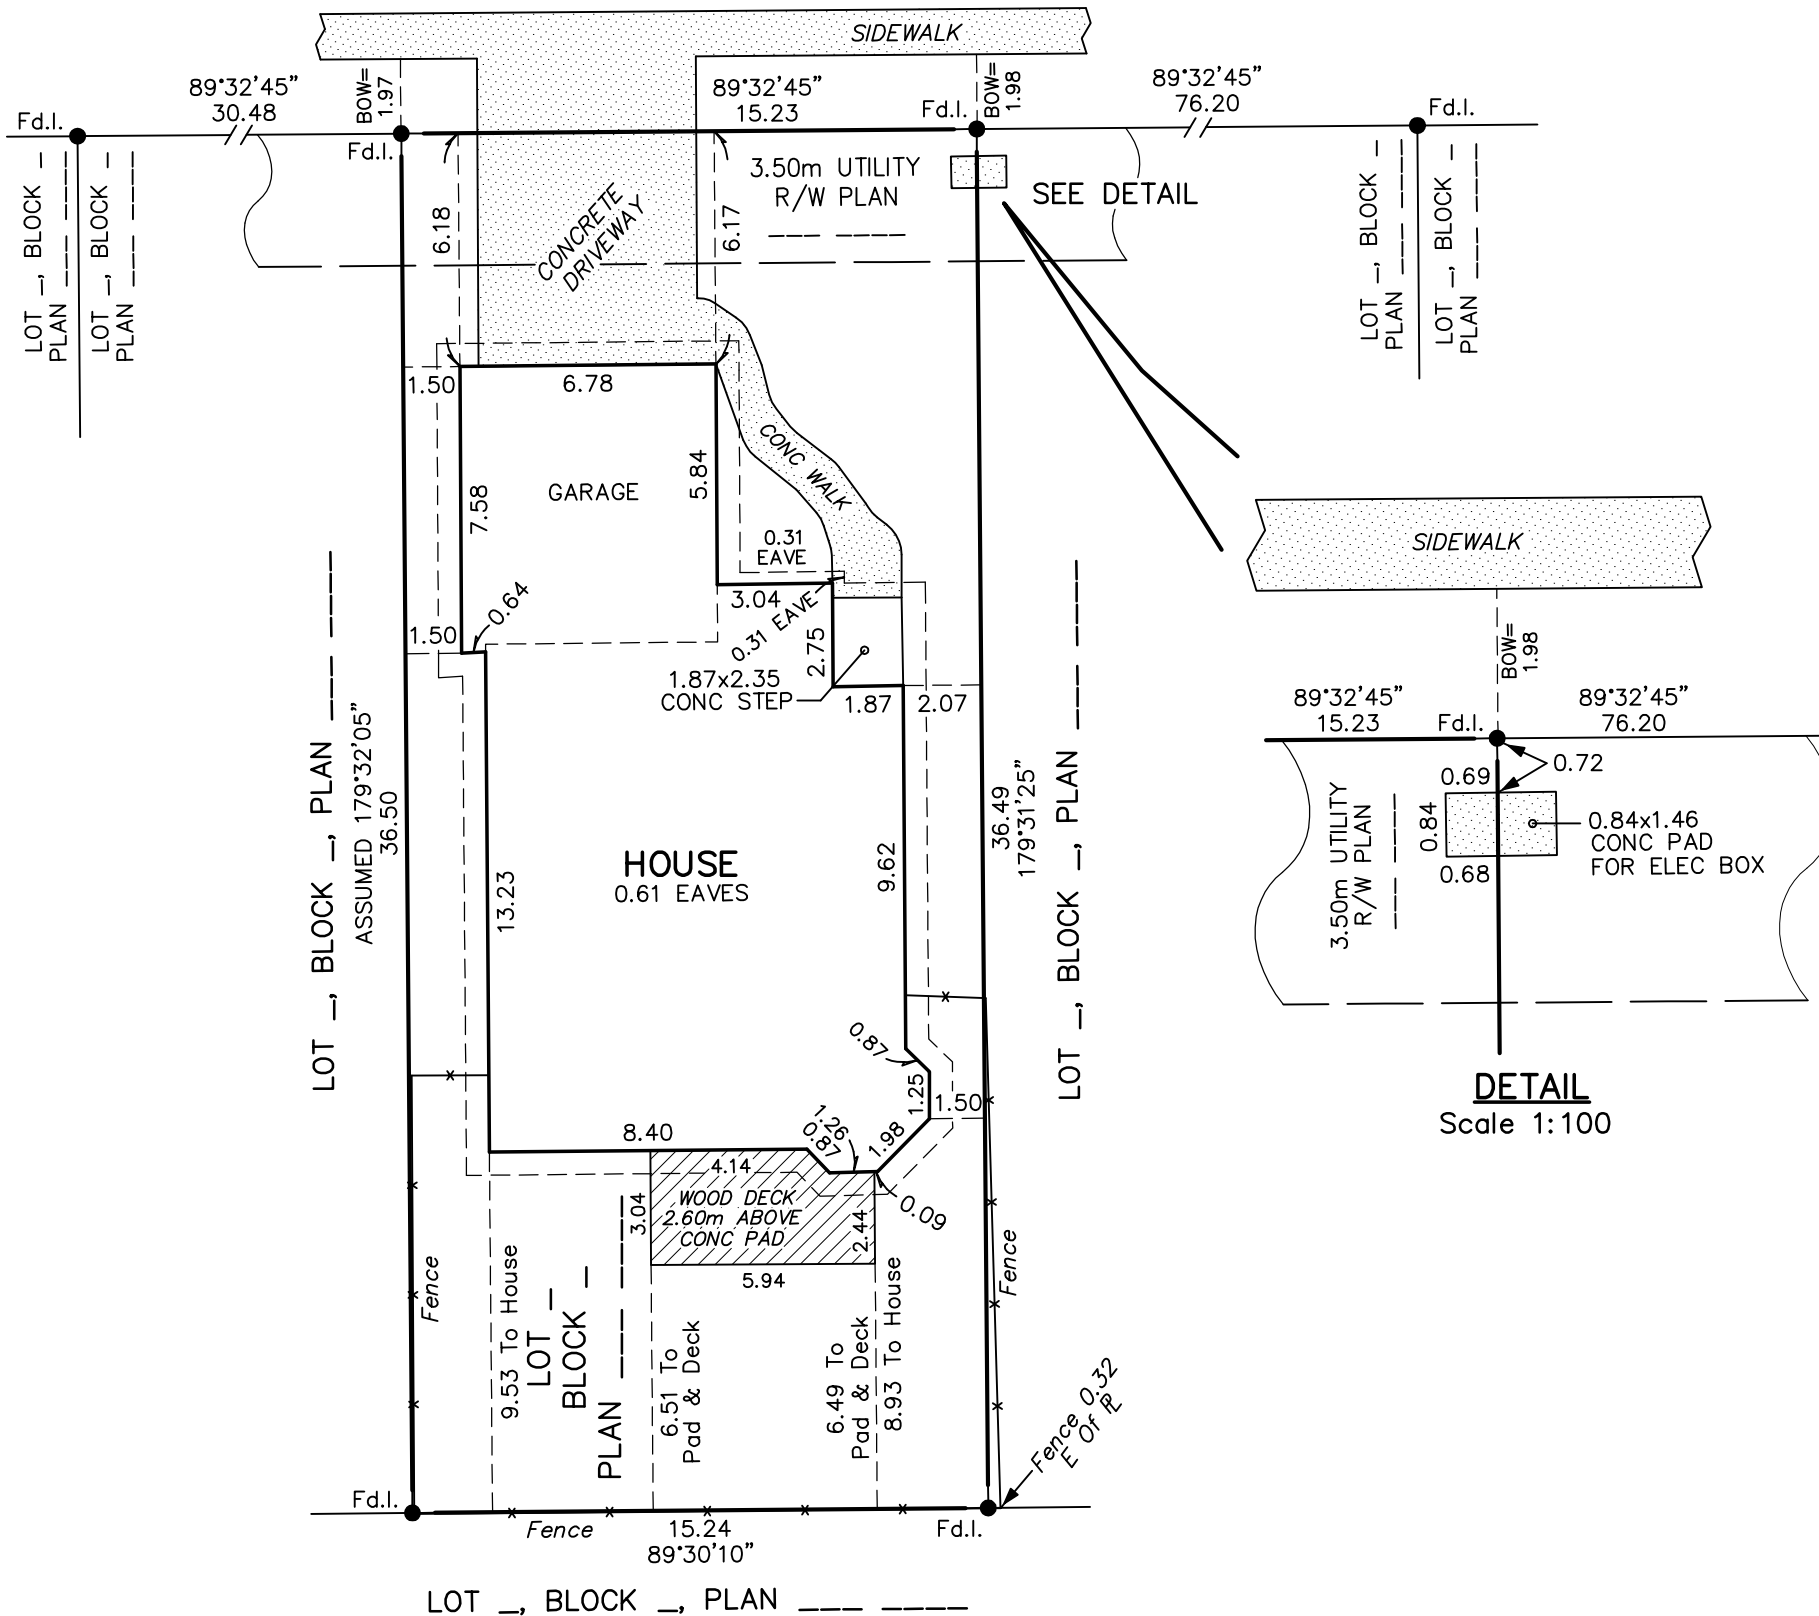

MUNICIPALITY: TOWN OF PEACE RIVER, ALBERTA
 DESCRIPTION OF PROPERTY: LOT ____, BLOCK ____, PLAN ____
 MUNICIPAL ADDRESS: _____, PEACE RIVER, ALBERTA
 PREPARED FOR: JOHN DOE
 DATE OF SURVEY:
 DATE OF TITLE SEARCH:
 SCALE: 1:200

LEGEND:
 DISTANCES SHOWN ARE IN METRES AND DECIMALS THEREOF.
 MEASUREMENTS ARE TO THE FOUNDATION UNLESS SHOWN OTHERWISE.
 STATUTORY IRON POSTS ARE ABBREVIATED THUS I.
 FOUND IS ABBREVIATED THUS Fd.
 STATUTORY IRON POST FOUND IS SHOWN THUS ●
 BACK OF CURB IS SHOWN THUS BOC
 BACK OF WALK IS SHOWN THUS BOW
 FENCE LINES ARE SHOWN THUS X X X
 FENCES ARE WITHIN 0.2m OF THE THE PROPERTY LINE,
 UNLESS SHOWN OTHERWISE.

CERTIFICATION:
 I hereby certify that this Report was prepared under my personal supervision and in accordance with the Manual of Standard Practice of the Alberta Land Surveyor's Association and supplements thereto. Accordingly within those standards as of the date of this Report, I am of the opinion that:

- the Plan illustrates the boundaries of the Property, the permanent visible improvements situated thereon (the "improvements"), registered easements and right-of-way affecting the Property,
- the improvements are entirely within the boundaries of the Property
- no visible encroachments exist on the Property from any improvements situated on any adjacent property _____
- no visible encroachments exist on utility right-of-way, other right-of-way or easements within the Property boundaries _____

PURPOSE:
 We (I) have performed this survey and prepared this Report and the related plan for the benefit of only; the landowner, subsequent owners and any of their agents, and was prepared to facilitate sale. Copying is permitted only for the benefit of those parties and only if the plan remains attached to this page. Where applicable, registered easements, utility right-of-ways and other registered instruments affecting the extent of the property have been shown on the attached plan. Unless otherwise shown, property corner markers have not been placed during the survey for this report. Do not use this plan to establish boundaries due to high risk of the user making an error in measurement. The information shown on this Real Property Report reflects the status of this property as of the date of survey only. Users are encouraged to have Real Property Report updated for future requirements.

Dated at PEACE RIVER, Alberta this _____ day of _____, 2009.

JARL NOME, ALS
 THIS DOCUMENT IS NOT VALID UNLESS IT BEARS AN ORIGINAL SIGNATURE (IN BLUE INK) AND A PERMIT STAMP (IN RED INK)
 THIS PLAN IS PROTECTED BY COPYRIGHT AND NO PERSON MAY COPY, REPRODUCE, DISTRIBUTE OR ALTER THIS PLAN IN WHOLE OR IN PART WITHOUT THE WRITTEN PERMISSION OF GEOSPARK SURVEYS INC. © 2009

GEOSPARK SURVEYS INC.
 P.O. Box 5159, 10010 - 98 Street
 Peace River, Alberta, T8S 1R8
 ACAD FILE: GSIP-_____-____
 FILE No: GSIP-_____-____